



DEFINITIVE MAP MODIFICATION ORDER APPLICATION PRIORITISATION

Application	Application to amend location of the definitive line of footpath FH-685, Feckenham
File Ref	M-2035
Applicant	H2Land Ltd, Stratford upon Avon CV37 0LJ
Date Submitted	20 November 2019

Application Prioritisation Criteria	Score
Conflict Resolution	3
Development	3
Effective use of Resources	1
Level of Support	1
The Wider Public Rights of Way Network and ROWIP Objectives	1
Total	9

Details of how these have been prioritized can be found in the DMMO Application Prioritisation Standard Operational Procedure

Summary of Information provided for Definitive Map Modification Order

The information below provides a summary for accessibility purposes of the scanned original application form documents attached.

Application Reference. M-2035

Applicant Name

H2Land Ltd

Applicant Address

Barley House, Cedar Drive, Snitterfield, Stratford upon Avon CV37 0LJ

The above hereby apply for an order under section 53(2) of the Wildlife and Countryside Act 1981 modifying the definitive map and statement for the area by:

Varying the particulars relating to the footpath no. FH-685 from kerb of Droitwich Road, Feckenham to rear of Lavender Place by providing that clarification that the footpath is different on the ground to that recorded on the current definitive map.

And shown on the map accompanying this application.

Dated and signed

20 November 2019

Confirmation was also submitted that Notice was served by the applicant on the following landowners of this application being made.

133 Long Lane, Aughton, Lancashire L39 5BT
The Chantry, Wroxton, Banbury OX15 6QS
6 Midsummer Meadow, Inkberrow WR7 4HD
Meadow View, Hall Road, West Berghott CO6 3DS
Chadbury Farm, Chadbury, Evesham, WR11 4TD
Lavender Place, Droitwich Road, Feckenham B96 6JE

Scanned application documents



M.O.1 Amended 7 Mar 2019

NOTICE OF APPLICATION FOR MODIFICATION ORDER
WILDLIFE AND COUNTRYSIDE ACT 1981

TO: MAPPING MANAGER, PUBLIC RIGHTS OF WAY TEAM, WORCESTERSHIRE
COUNTY COUNCIL
OF: WORCESTER WOODS COUNTRY PARK, WILDWOOD DRIVE, WORCESTER
WR5 2LG


I/We..... H2LAND LTD
of BALBY HOUSE, CEDAR DRIVE, SNITFLETON, STURFORD UPON AVON CV37 0LW
Email address & Tel No. mark@h2land.co.uk 0789 730940

hereby apply for an order under Section 53(2) of the Wildlife and Countryside Act 1981
modifying the definitive map and statement for the area by:

- i. ~~Deleting~~ footpath / bridleway / restricted byway / byway open to all traffic (No.....)
From.....
To.....
- ii. ~~Adding~~ a footpath / bridleway / restricted byway / byway open to all traffic
From.....
To.....
- iii. ~~Upgrading/downgrading~~ footpath / bridleway / restricted byway / byway open to all traffic (No.....) to the new status of footpath / bridleway / restricted byway / byway open to all traffic.
From.....
To.....
- iv. Varying (adding to) the particulars (the definitive statement) relating to the footpath / bridleway / restricted byway / byway open to all traffic (No F.H.685)
From kerb of Droitwich Road, Feckenham
To near of Lavender Place,
By providing that clarification that the footpath is different on the ground to that recorded on the current definitive map.
and shown on a map accompanying this application.

I/We attach have provided a separate list of documentary evidence (including witness statements, maps etc. in support of this application. (YES/NO)

Dated 20/11 2019. Signed

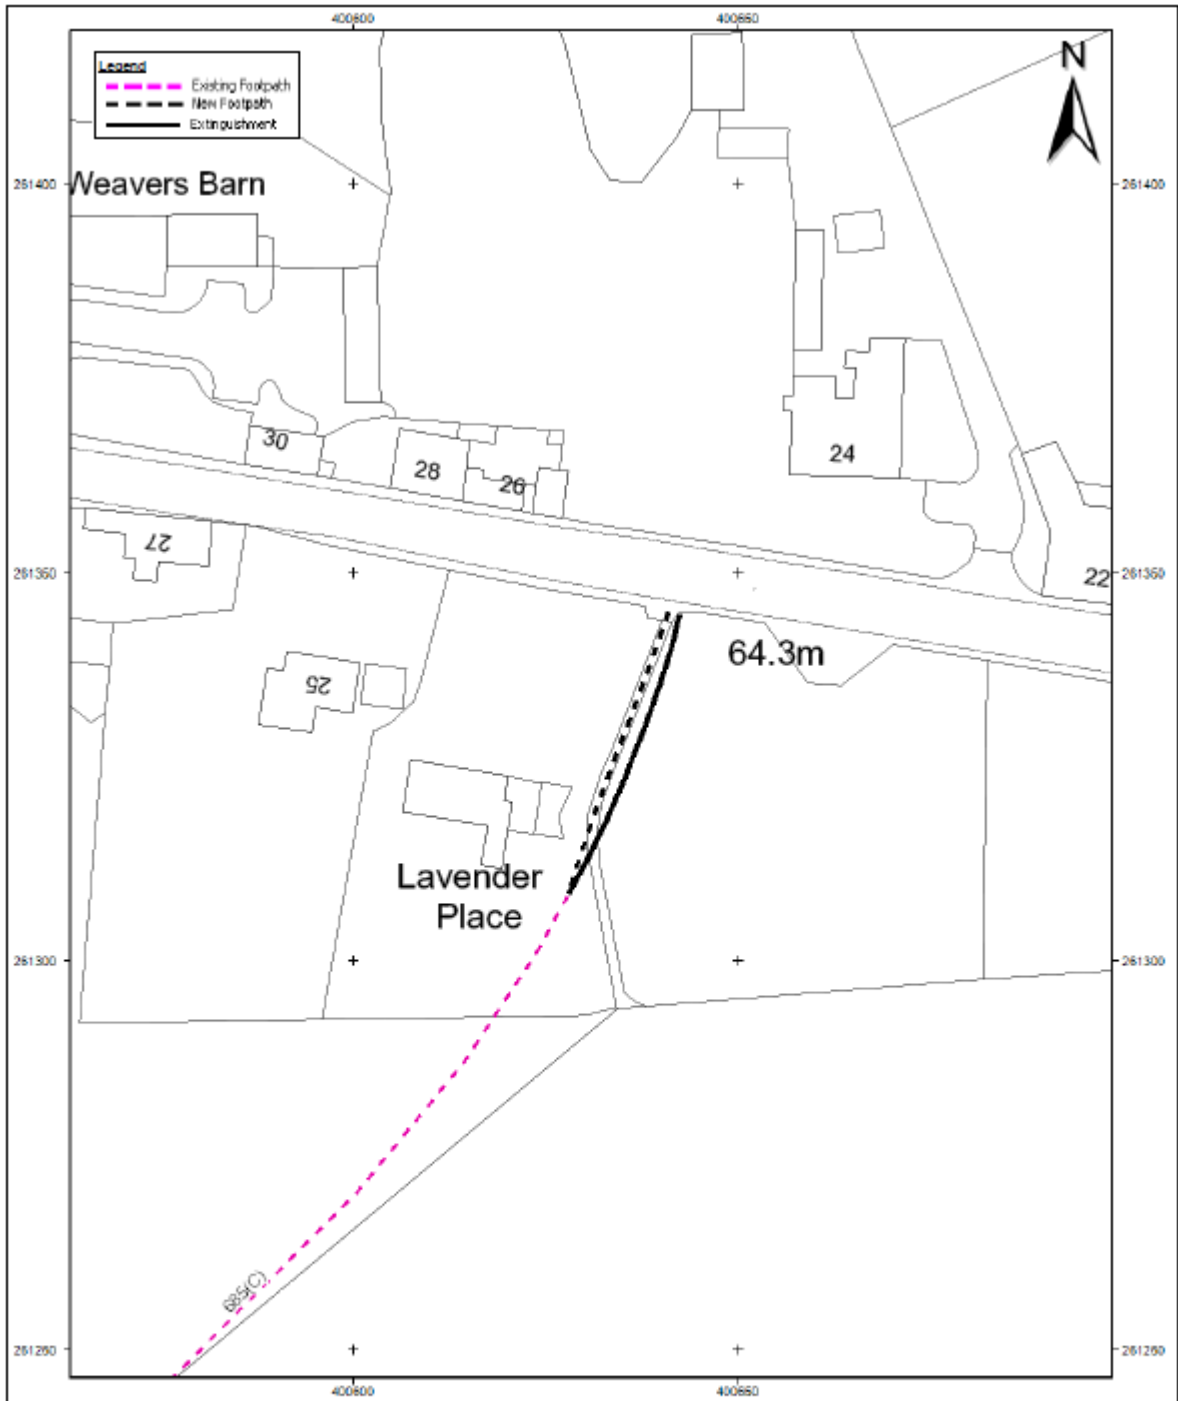

© Crown copyright and database rights 2020
Ordnance Survey 100024230.

Indicative Scale: 1:800

Date Printed: 22/1/2020

0 5 25 50 metres

**DEFINITIVE MAP MODIFICATION ORDER
TO AMEND THE DEFINITIVE LINE OF
FOOTPATH FH-685 IN THE PARISH OF
FECKENHAM
BOROUGH OF REDDITCH**

worcestershire
county council

Countryside Service
Worcester Woods Country Park
Wildwood Drive
Worcester
WR5 2LG